

Date: Wednesday, 2/20/2008 4:16:17 PM
 User: Kim Johnston

Process Sheet

10

Customer : CU-DAR001 Dart Helicopters Services	Drawing Name : BASKET BASE ASSEMBLY (350)
Job Number : 37511C	
Estimate Number : 10189	
P.O. Number :	Part Number : D2221
This Issue : 2/20/2008 S.O. No. :	Drawing Number : D2221 U/R, D2235
Prsht Rev. : NC	Project Number : N/A
First Issue : / / Type : LARGE FAB ASSY	Drawing Revision : F/B1
Previous Run : 37247C	Material :
Written By :	Due Date : 3/7/2008 Qty: 1 Um: Each
Checked & Approved By : <u>JA 08 02 21</u>	
Comment : Est Rev:J 05.09.02 Added D3442-1 KJ/JLM	

Additional Product

Job Number:



Seq. #:	Machine Or Operation:	Description :
---------	-----------------------	---------------

1.0	D31661	Basket Hoop
-----	--------	-------------



Comment: Qty.: 4.0000 Each(s)/Unit Total : 4.0000 Each(s)

Pick:

Qty Part Number Description Batch

4 D3166-1 RIB

M37882

FC 08 04 21

2.0	D22323	Basket Hinge
-----	--------	--------------



Comment: Qty.: 2.0000 Each(s)/Unit Total : 2.0000 Each(s)

Pick:

Qty Part Number Description Batch

2 D2232-3 Hinge bracket

B36846

PD 08-04-24

3.0	D2325	Support Gusset (350 Bask
-----	-------	--------------------------



Comment: Qty.: 4.0000 Each(s)/Unit Total : 4.0000 Each(s)

Pick:

Qty Part Number Description Batch

4 D2325 Support Gusset

B36691

PD 08-04-24

4.0	D23273	Spacer Bushing
-----	--------	----------------



Comment: Qty.: 2.0000 Each(s)/Unit Total : 2.0000 Each(s)

Pick:

Qty Part Number Description Batch

2 D2327-3 Bushing

B37851

FC 08-04-21

W/O:		WORK ORDER CHANGES					
DATE	STEP	PROCEDURE CHANGE	By	Date	Qty	Approval Chief Eng / Prod Mgr	Approval QC Inspector

Part No: _____ PAR #: _____ Fault Category: _____ NCR: Yes No DQA: _____ Date: _____

QA: N/C Closed: _____ Date: _____

NCR:		WORK ORDER NON-CONFORMANCE (NCR)						
DATE	STEP	Description of NC Section A	Corrective Action Section B			Verification Section C	Approval Chief Eng	Approval QC Inspector
			Initial Chief Eng	Action Description Chief Eng	Sign & Date			

NOTE: Date & initial all entries

Date: Wednesday, 2/20/2008 4:16:17 PM
User: Kim Johnston

Process Sheet

Customer: CU-DAR001 Dart Helicopters Services

Drawing Name: BASKET BASE ASSEMBLY (350)

Job Number: 37511C

Part Number: D2221

Job Number:



Seq. #:

Machine Or Operation:

Description :

5.0

D2581

Mounting Bracket



Comment: Qty.: 2.0000 Each(s)/Unit Total : 2.0000 Each(s)

Pick:

Qty Part Number Description Batch

2 D2581 Mounting Bracket 037248

FC 08 04 24

6.0

D34421

Shim



Comment: Qty.: 2.0000 Each(s)/Unit Total : 2.0000 Each(s)

Pick:

Qty Part Number Description Batch 037615

2 D3442-1 Shim

~~034421~~

PD 08-04-24

7.0

M304EX07516F

Expanded Metal Flat Stai



Comment: Qty.: 41.6745 sf(s)/Unit Total : 41.6745 sf(s)

Pick:

Qty Part Number Description Batch

39.69 sf M304EX0.75-16F Expanded Metal M107511

FC 08 04 24

8.0

M304TS0750W065

304 SQ Tube .75x.75x.065W



Comment: Qty.: 29.4000 f(s)/Unit Total : 29.4000 f(s)

Pick:

28" 3/4" x 3/4" x 0.063 wall 304/316 SStubing

Batch: M107514

0.065 ~~0.063~~

PD 08-04-24

9.0

LARGE FAB 1

LARGE FABRICATION RESOURCE 1



Comment: LARGE FABRICATION RESOURCE 1

1-Cut D2235-1 Rib from D3166-1 Rib As Per Dwg D2235

2-Drill hole in D2221-3 as per Dwg D2221

PD 08-04-24

3-Deburr

PD 08-04-24

4-Remove all markings on material before welding

PD 08-04-24

5-Weld as per Dwg D2221 using Welding Table and corner JigDeburr as required

PD 08-04-24

W/O:		WORK ORDER CHANGES					
DATE	STEP	PROCEDURE CHANGE	By	Date	Qty	Approval Chief Eng / Prod Mgr	Approval QC Inspector

Part No: _____ PAR #: _____ Fault Category: _____ NCR: Yes No DQA: _____ Date: _____

QA: N/C Closed: _____ Date: _____

NCR:		WORK ORDER NON-CONFORMANCE (NCR)						
DATE	STEP	Description of NC Section A	Corrective Action Section B			Verification Section C	Approval Chief Eng	Approval QC Inspector
			Initial Chief Eng	Action Description Chief Eng	Sign & Date			

NOTE: Date & initial all entries

Date: Wednesday, 2/20/2008 4:16:17 PM
User: Kim Johnston

Process Sheet

Customer: CU-DAR001 Dart Helicopters Services

Drawing Name: BASKET BASE ASSEMBLY (350)

Job Number: 37511C

Part Number: D2221

Job Number:



Seq. #:

Machine Or Operation:

Description :

10.0

QC9

VISUAL WELDING INSPECTION



Comment: VISUAL WELDING INSPECTION

08/04/25

11.0

QC6

DIMENSIONAL CHECK



Comment: DIMENSIONAL CHECK

08/04/25

30 min

12.0

POWDER COATING

POWDER COATING



Comment: POWDER COATING

Powder Coat White Gloss (Ref: 4.3.5.1) as per QSI 005 4.3

M107550

08/04/25

26/04/2008

S.122 08.01

#1 395.6

#2 337511C

#3

#4 D2221

13.0

QC3

INSPECT POWDER COAT/CHEMICAL CONVERSION



Comment: INSPECT POWDER COAT/CHEMICAL CONVERSION

08/04/28

14.0

QC21

FINAL INSPECTION/W/O RELEASE



Comment: FINAL INSPECTION/W/O RELEASE

08/04/28

Job Completion



u 8-04-28

W/O:		WORK ORDER CHANGES					
DATE	STEP	PROCEDURE CHANGE	By	Date	Qty	Approval Chief Eng / Prod Mgr	Approval QC Inspector

Part No: _____ PAR #: _____ Fault Category: _____ NCR: Yes No DQA: _____ Date: _____

QA: N/C Closed: _____ Date: _____

NCR:		WORK ORDER NON-CONFORMANCE (NCR)						
DATE	STEP	Description of NC Section A	Corrective Action Section B			Verification Section C	Approval Chief Eng	Approval QC Inspector
			Initial Chief Eng	Action Description Chief Eng	Sign & Date			

NOTE: Date & initial all entries



DESIGN BW	DRAWN BY PH	DART AEROSPACE LTD HAWKESBURY, ONTARIO, CANADA	
CHECKED <i>[Signature]</i>	APPROVED <i>[Signature]</i>	DRAWING NO. D2221	REV. F SHEET 1 OF 3
DATE 05.06.07		TITLE BASKET BASE ASSEMBLY (350)	SCALE NTS
C	95.11.21	SEPARATE BASKET AND LID	
D	96.06.21	CHANGE LATCH	
E	01.04.19	CHANGE HINGE	
F	05.06.07	ADD SHIM UNDER HINGES, ADD HOLES FOR SPLIT LID BASKETS	


RELEASED

05.08.19 *[Signature]*

PARTS LIST FOR D2221 BASKET BASE ASSEMBLY

PART NO	QUANTITY	LENGTH A	LENGTH B	DESCRIPTION
D2221-1	2	—	96.00	RIB
D2221-3	2	—	25.50	RIB
D2221-5	2	18.88	—	RIB
D2221-7	1	55.25	—	RIB
D2232-3	2	N/A	N/A	HINGE PLATE
D2235-1	4	N/A	N/A	RIB
D2325	4	N/A	N/A	SUPPORT GUSSET
D2327-3	2	N/A	N/A	BUSHING
D2581	2	N/A	N/A	MTG BRKT
D3442-1	2	N/A	N/A	SHIM

SHOP COPY
RETURN TO
ENGINEERING
UNCONTROLLED COPY
SUBJECT TO AMENDMENT
WITHOUT NOTICE
WORK ORDER
NO. 37511C

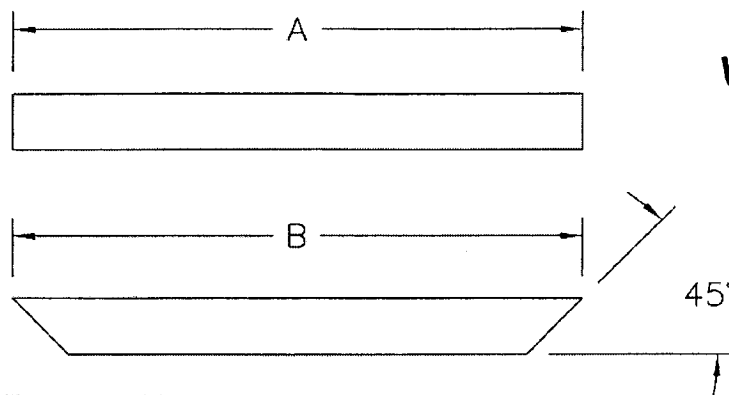

UNDER REVIEW


08.02.05 PH
TUBING TO BE
CHANGED TO 0.065
WALL

D2221-1/-3/-5/-7


- 1) CUT LENGTH/SHAPE PER DIAGRAM AND PARTS LIST
- 2) MATERIAL: AISI 304/316 SS, 3/4 X 3/4 X 0.060 WALL SQUARE TUBING
(REF. DART SPEC M304TS0.750W.060) *0.065 PH 03.02.01*
- 3) TOLERANCES ARE PER DART QSI 018 UNLESS OTHERWISE NOTED
- 4) ALL DIMENSIONS ARE IN INCHES
- 5) DRILL $\phi 0.257$ HOLES ONLY WHEN ASSEMBLING D2221 BASE WITH D2989-041/-043 BASKET LID

Copyright © 1994 by DART AEROSPACE LTD

THIS DOCUMENT IS PRIVATE AND CONFIDENTIAL AND IS SUPPLIED ON THE EXPRESS CONDITION THAT IT IS NOT TO BE USED FOR ANY PURPOSE OR COPIED OR COMMUNICATED TO ANY OTHER PERSON WITHOUT WRITTEN PERMISSION FROM DART AEROSPACE LTD.

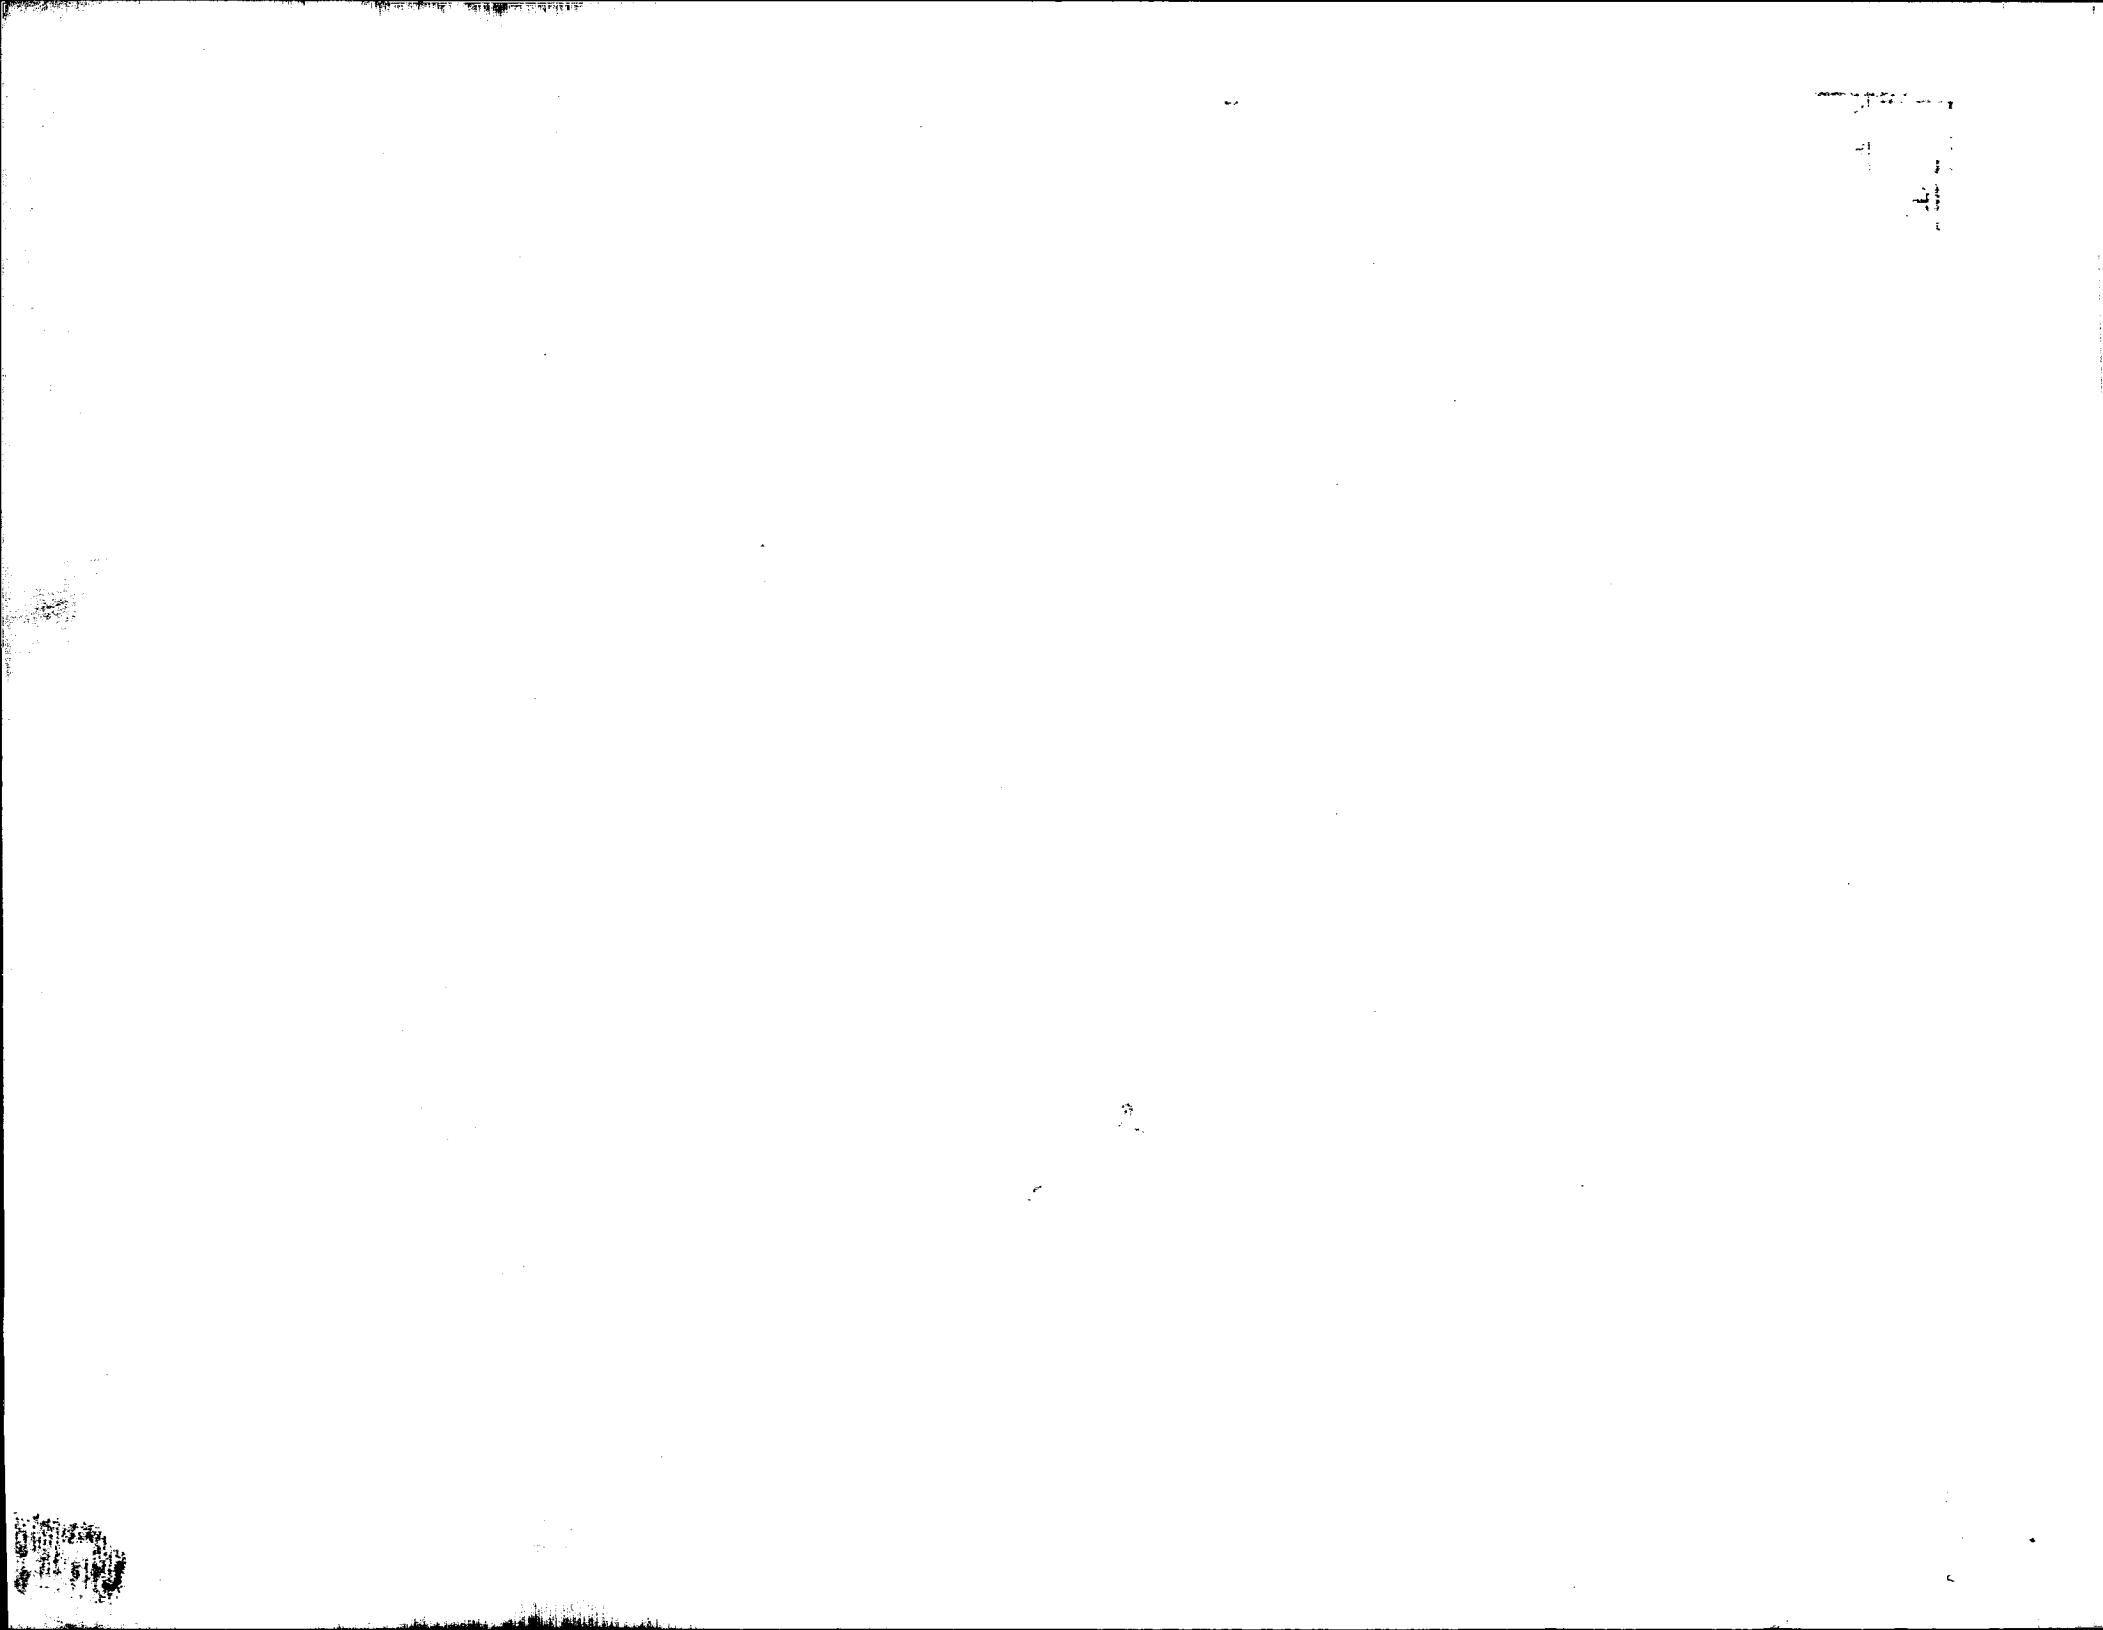

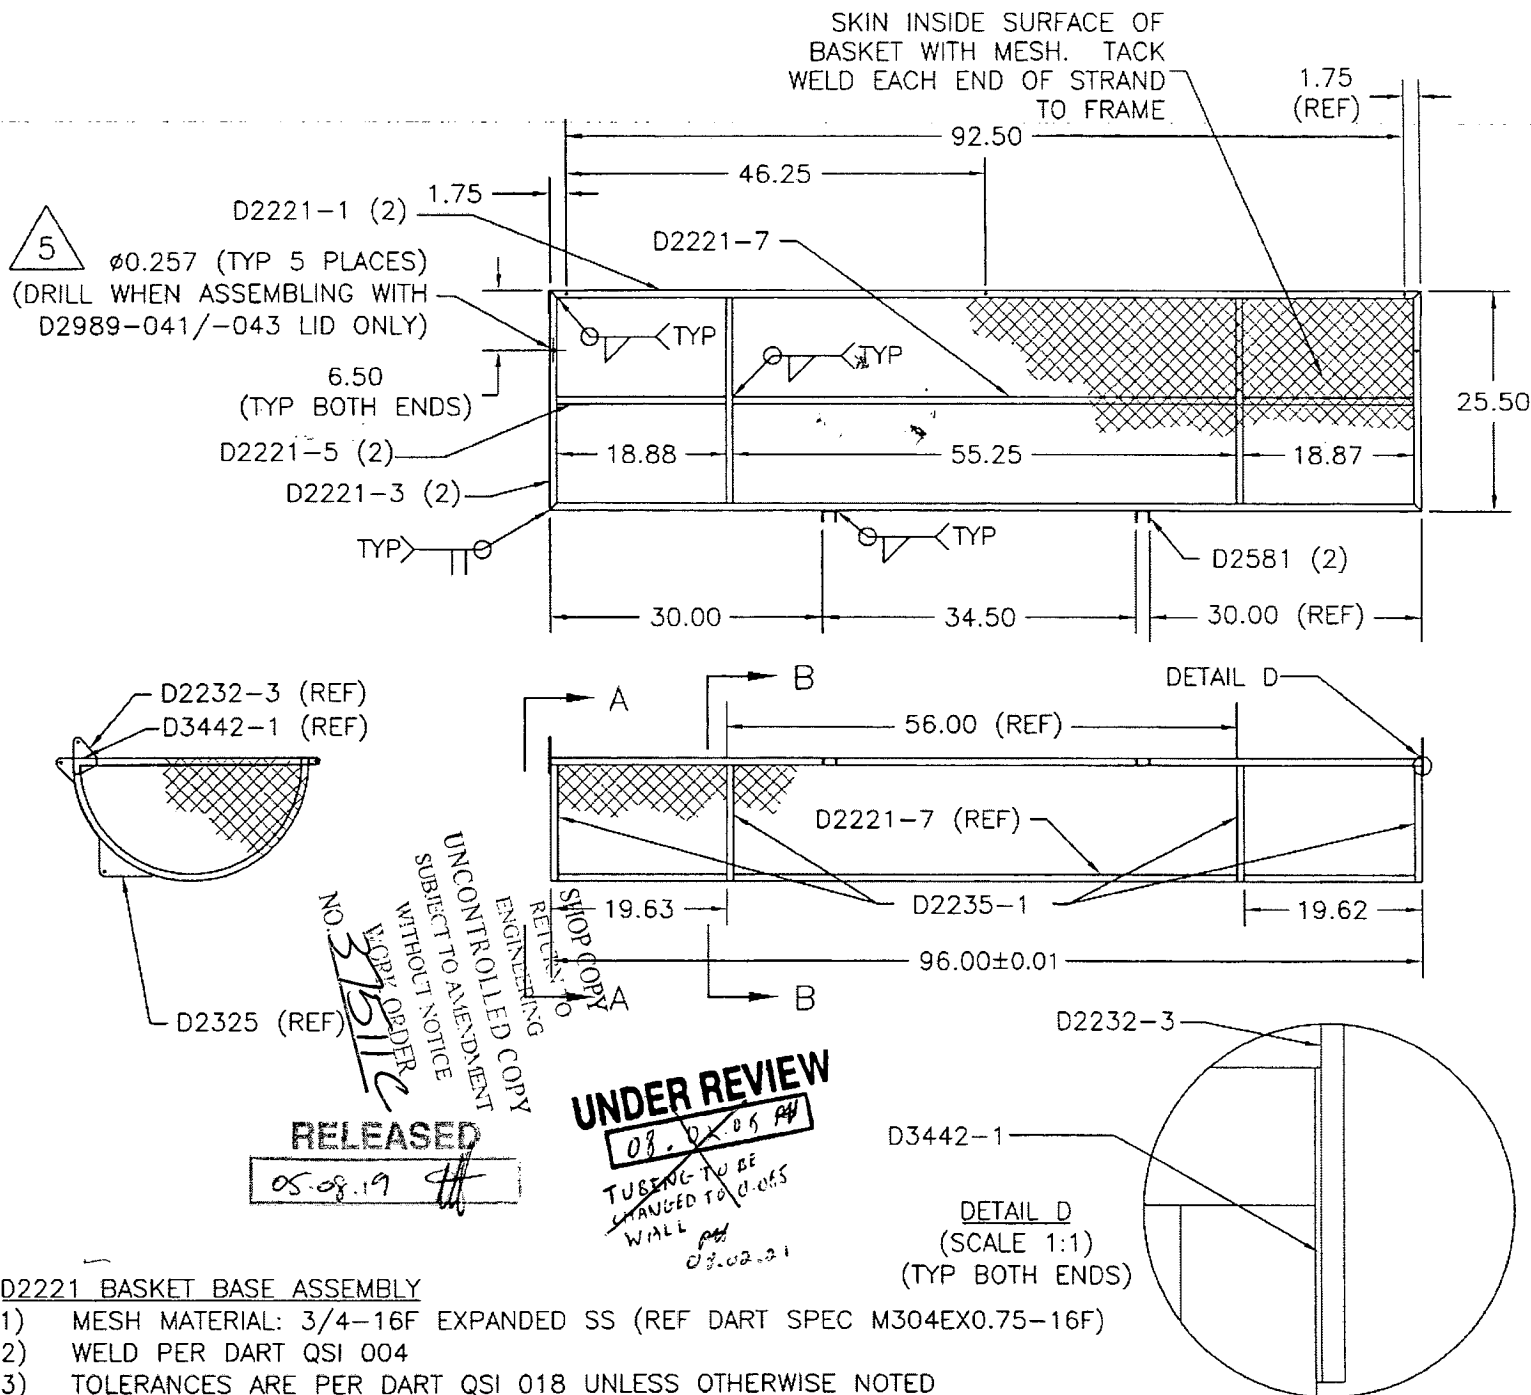

DART



D2221 BASKET BASE ASSEMBLY

- 1) MESH MATERIAL: 3/4-16F EXPANDED SS (REF DART SPEC M304EX0.75-16F)
- 2) WELD PER DART QSI 004
- 3) TOLERANCES ARE PER DART QSI 018 UNLESS OTHERWISE NOTED
- 4) FINISH: POWDER COAT ENTIRE ASSEMBLY WHITE (4.3.5.2) PER DART QSI 005 4.3


DESIGN	DART AEROSPACE LTD HAMKESBURY, ONTARIO, CANADA		
BW	DRAWN BY PH		
CHECKED 	APPROVED 	DRAWING NO. D2221	REV. F SHEET 2 OF 3
DATE 05.06.07	TITLE BASKET BASE ASSEMBLY (350)		SCALE 1:20

THIS DOCUMENT IS PRIVATE AND IS SUPPLIED ON THE EXPRESS CONDITION THAT IT IS NOT TO BE USED FOR ANY PURPOSE OR COPIED OR COMMUNICATED TO ANY OTHER PERSON WITHOUT WRITTEN PERMISSION FROM DART AEROSPACE LTD.

Copyright © 1994 by DART AEROSPACE LTD




DESIGN BW	DRAWN BY PH	DART AEROSPACE LTD HAWKESBURY, ONTARIO, CANADA	
CHECKED <i>[Signature]</i>	APPROVED <i>[Signature]</i>	DRAWING NO. D2221	REV. F SHEET 3 OF 3
DATE 05.06.07	TITLE BASKET BASE ASSEMBLY (350)		SCALE 1:8

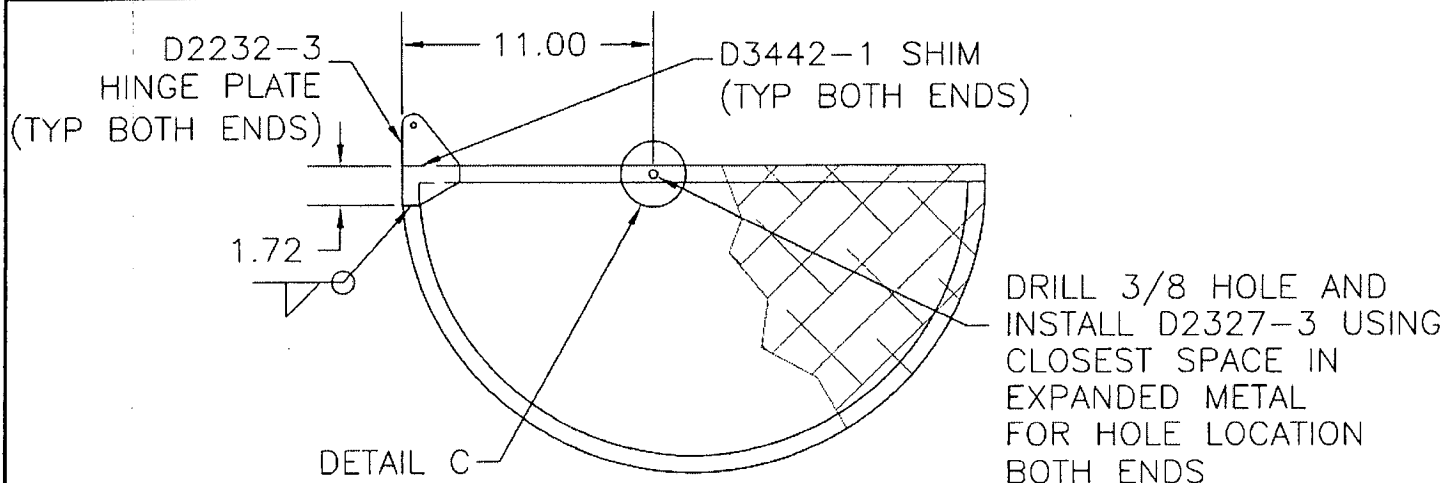


SECTION A-A SAME BOTH END RIBS

UNDER REVIEW

08-02-06 PH
TUBING TO BE
CHANGED TO 0.055
WALL
08-02-01

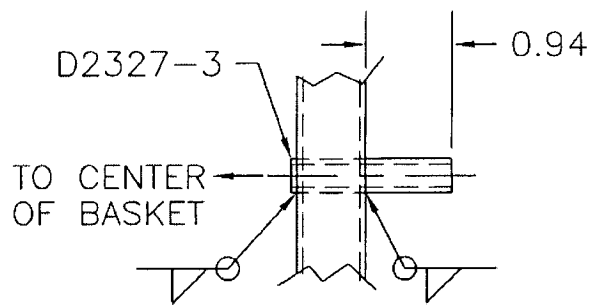

DETAIL C

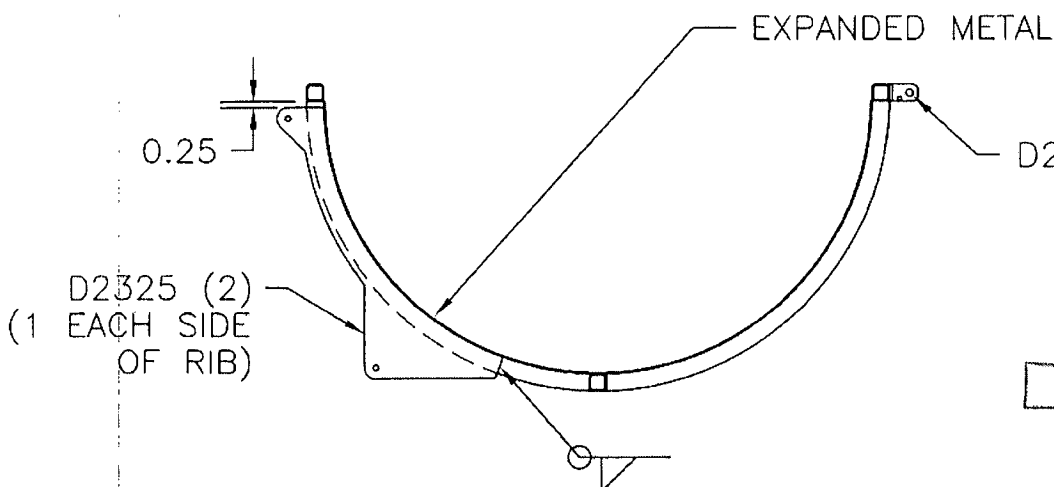

SECTION B-B SAME BOTH CENTER RIBS

SHOP COPY
RETURN TO
ENGINEERING
UNCONTROLLED COPY
SUBJECT TO AMENDMENT
WITHOUT NOTICE
WORK ORDER
NO. 37511C

RELEASED

05-08-19 *[Signature]*


Copyright © 1994 by DART AEROSPACE LTD

THIS DOCUMENT IS PRIVATE AND CONFIDENTIAL AND IS SUPPLIED ON THE EXPRESS CONDITION THAT IT IS NOT TO BE USED FOR ANY PURPOSE OR COPIED OR COMMUNICATED TO ANY OTHER PERSON WITHOUT WRITTEN PERMISSION FROM DART AEROSPACE LTD.




DESIGN	DRAWN BY	DART AEROSPACE LTD	
B WILLIAMS	B WILLIAMS	VICTORIA INTERNATIONAL AIRPORT, CANADA	
CHECKED	APPROVED	DRAWING NO.	REV. B
<i>[Signature]</i>	<i>[Signature]</i>	D2235	SHEET 1 OF 1
DATE	TITLE		SCALE
94:12:16	BASKET RIBS		
BI	02.08.06 <i>[Signature]</i>	CAN BE MADE FROM D3166-1	

RELEASED
R 960507

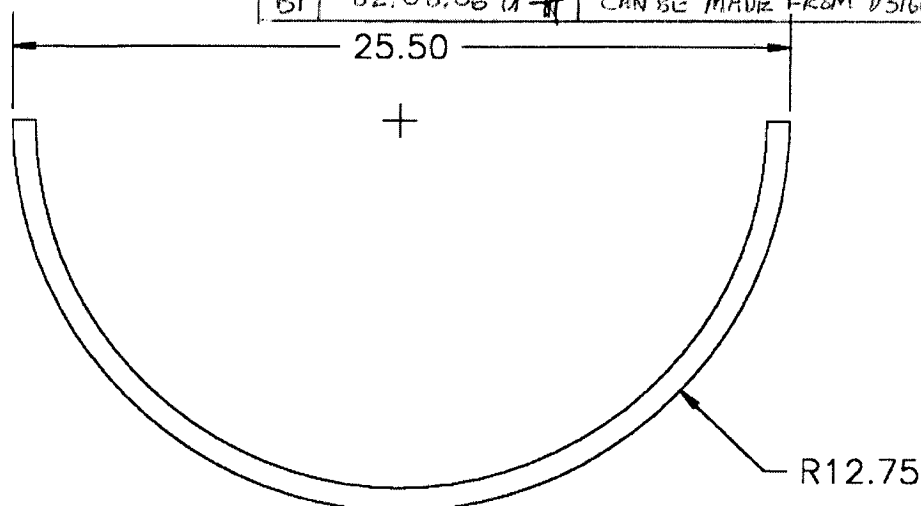


D2235-1

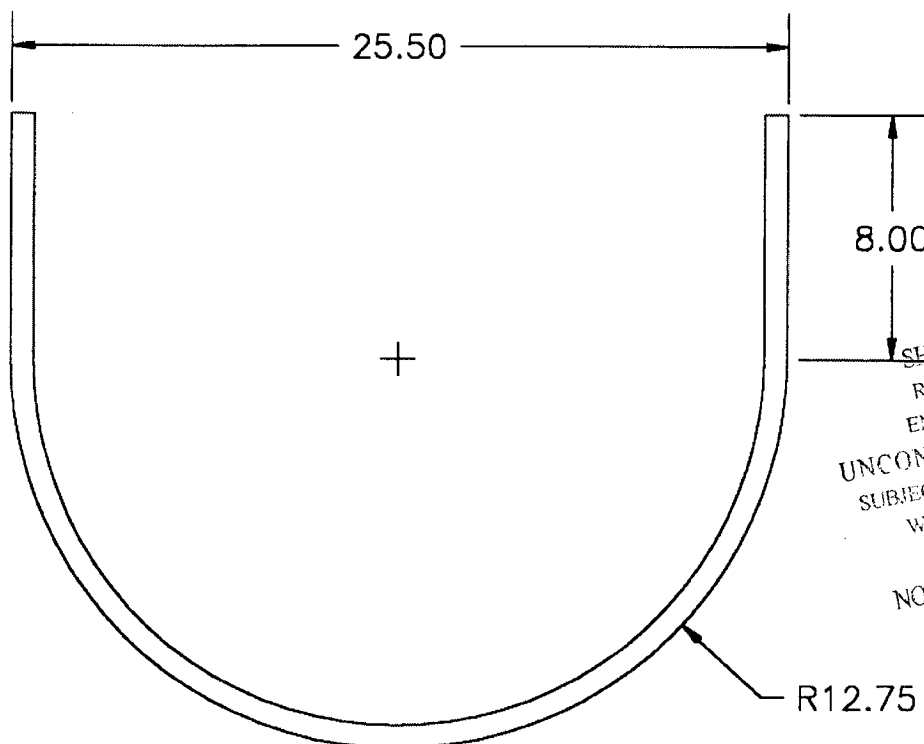

SHOP COPY
RETURN TO
ENGINEERING
UNCONTROLLED COPY
SUBJECT TO AMENDMENT
WITHOUT NOTICE
WORK ORDER
NO. 375114

D2235-3

CAN BE MADE FROM D3166-1 
MATERIAL: 304/316 SS, 3/4 X 3/4 X 0.063 WALL SQR.

